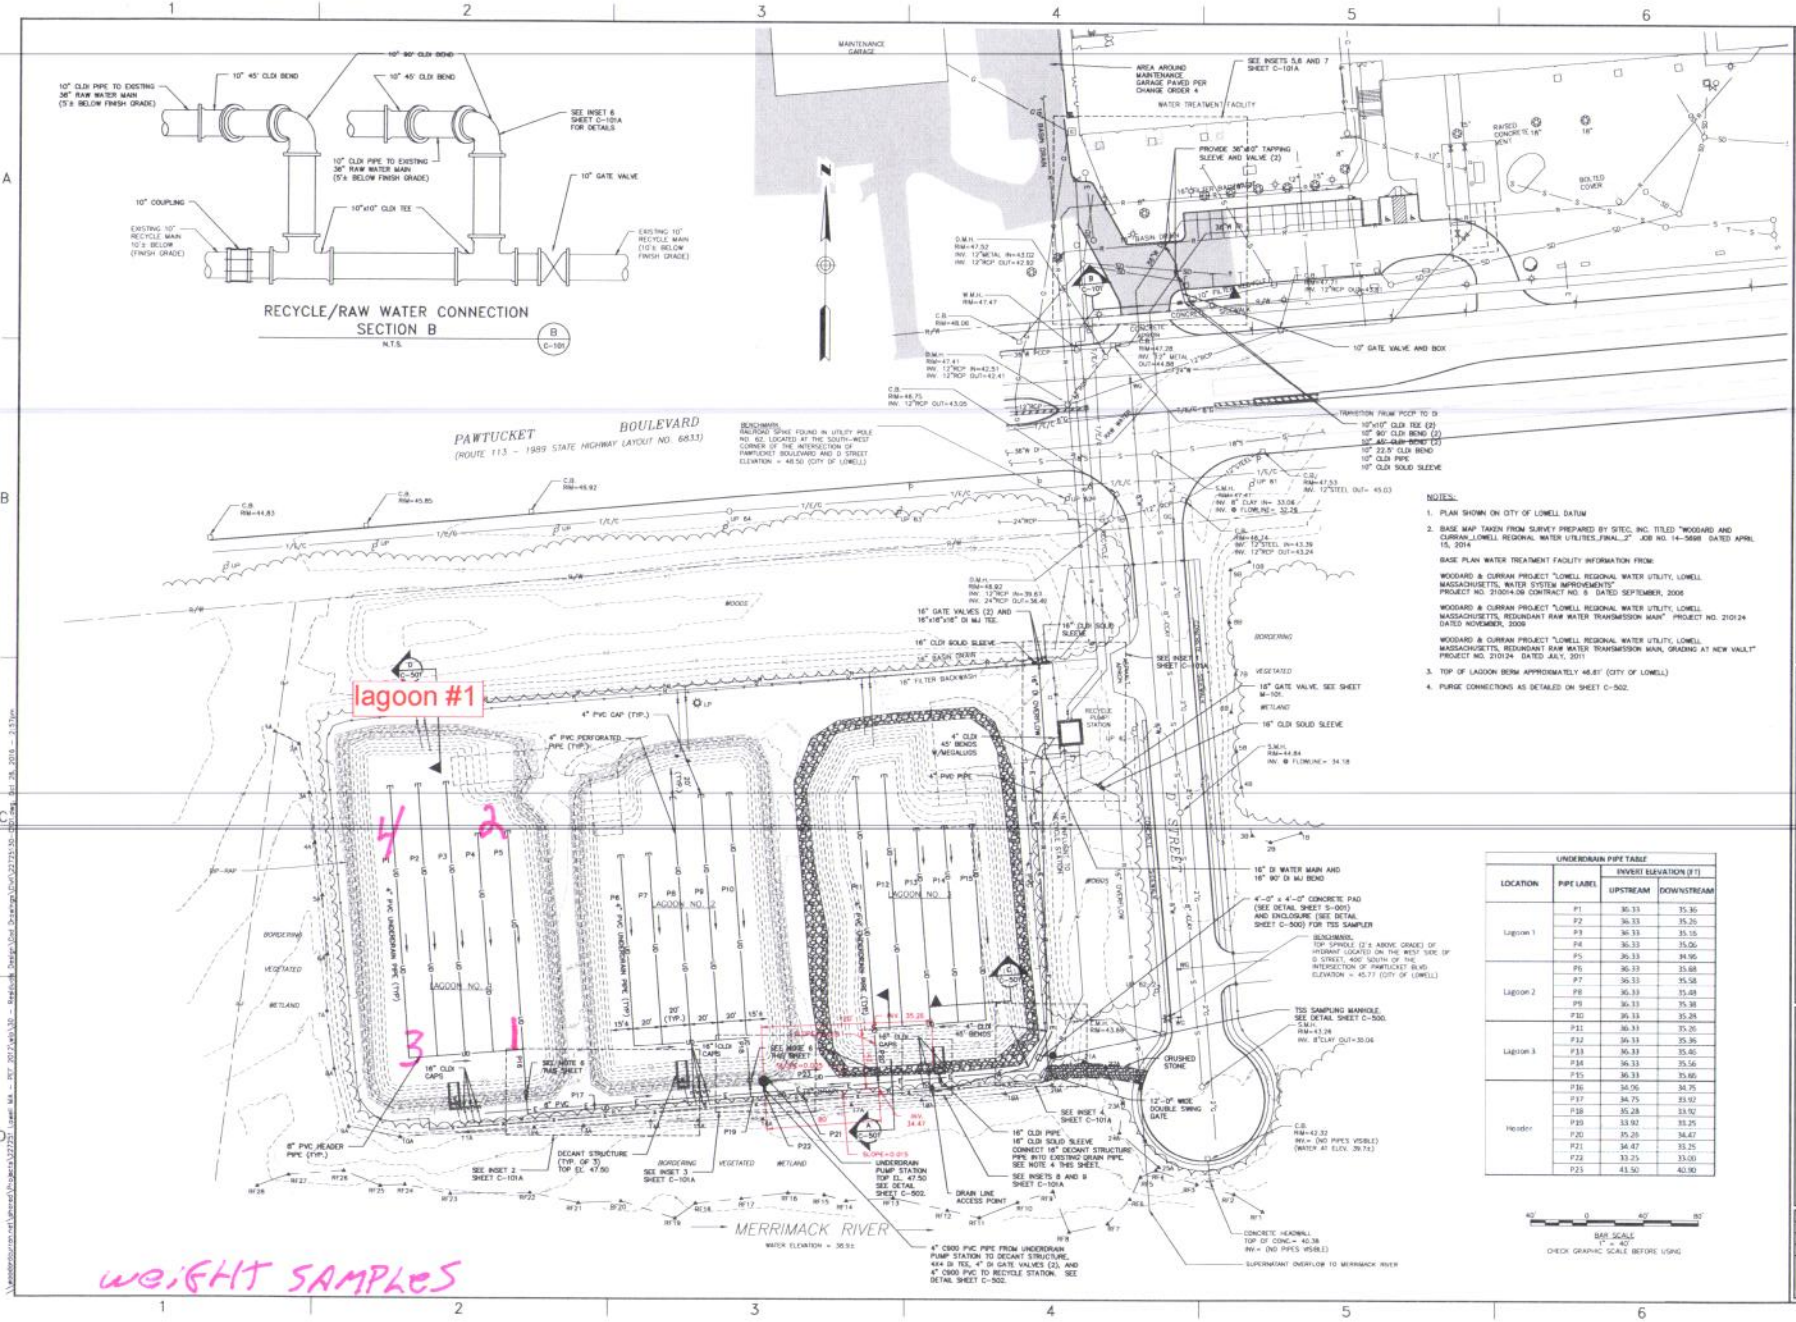

UNDERDRAIN PIPE TABLE			
LOCATION	PIPE LABEL	INVERT ELEVATION (FT)	
		UPSTREAM	DOWNSTREAM
Lagoon 1	P1	36.33	35.36
	P2	36.33	35.26
	P3	36.33	35.16
	P4	36.33	35.06
	P5	36.33	34.96
Lagoon 2	P6	36.33	35.68
	P7	36.33	35.58
	P8	36.33	35.48
	P9	36.33	35.38
	P10	36.33	35.28
Lagoon 3	P11	36.33	35.26
	P12	36.33	35.36
	P13	36.33	35.46
	P14	36.33	35.56
	P15	36.33	35.66
Header	P16	34.06	34.75
	P17	34.75	33.92
	P18	35.28	33.92
	P19	33.92	33.25
	P20	35.20	34.47
	P21	34.47	33.25
	P22	33.25	33.00
	P23	41.50	40.90

WOODARD & CURRAN
40 Shattuck Road, Suite 110
Andover, Massachusetts 01810
978.792.8011 | www.woodardcurran.com
COMMITMENT & INTEGRITY DRIVE RESULTS

NO.	DESCRIPTION	DATE
	RECORD DRAWINGS	10/28/16
	ISSUED FOR BID	9/27/14

DESIGNED BY: RAL
DRAWN BY: JDB
CHECKED BY: RL
APPROVED BY: DJB

SITE PLAN (POST)

LOWELL REGIONAL WATER UTILITY
LOWELL, MASSACHUSETTS

RESIDUALS HANDLING FACILITIES UPGRADE

JOB NO: 22/251.30
DATE: OCTOBER 2016
SCALE: 1"=40'
SHEET: 3 OF 16

C-101