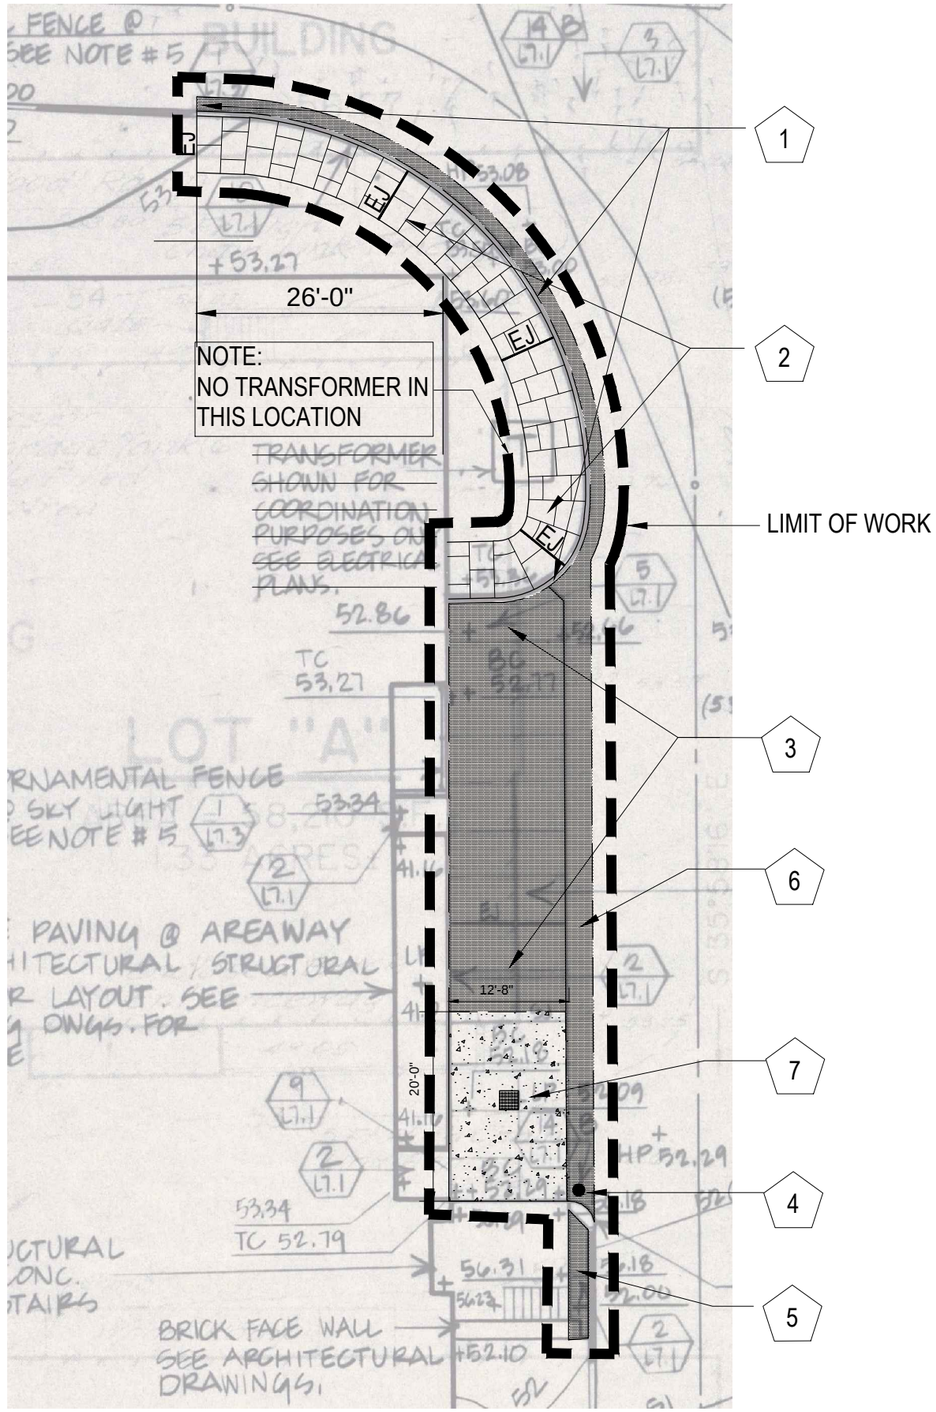

GENERAL NOTES:

1. PLANS HAVE BEEN COMPILED FROM CONSTRUCTION PLANS PROVIDED BY THE CITY OF LOWELL AND DO NOT DEPICT "AS-BUILT" CONDITIONS.

2. CONTRACTOR IS RESPONSIBLE FOR VERIFYING ALL DIMENSIONS AND ELEVATIONS PRIOR TO CONSTRUCTION ACTIVITIES. ANY CONFLICTS WITH THE PROPOSED REPAIRS SHALL BE BROUGHT TO THE OWNERS ATTENTION.

3. PROVIDE TEMPORARY FENCE AROUND ALL WORK AREAS. ALL TEMPORARY CONSTRUCTION FENCE OR ACCESS DETOURS SHALL BE COORDINATED AND APPROVED BY THE CITY OF LOWELL SCHOOL DEPARTMENT PRIOR TO CONSTRUCTION.

4. LOAM AND SEED ALL DISTURBED LANDSCAPED AREAS.

5. CONTRACTOR RESPONSIBLE FOR THE REMOVAL AND DISPOSAL OF ALL DEMOLISHED AND UNSUITABLE MATERIALS AS PER LOCAL, STATE AND FEDERAL REQUIREMENTS.

KEYNOTES:

1. SAWCUT PAVEMENT 18 INCHES FROM FACE OF CURB AND RESET CURB. (SEE DETAIL 1/C-501)

2. REMOVE AND REPLACE CONCRETE SIDEWALK WITH 3500 PSI REINFORCED CONCRETE. (SEE DETAIL 2/C-501) MATCH EXISTING PATTERN. A

3. REMOVE CONCRETE IN SHADED AREAS AND REPLACE WITH BITUMINOUS CONCRETE AS DETAILED. (SEE DETAIL 4/C-501.

4. REMOVE ABANDONED METAL VALVE BOX. BACKFILL AND COMPACT. VERIFY THAT IT IS INOPERABLE.

5. REPLACE CONCRETE APRON WITH 2.5" OF FINISH COURSE BITUMINOUS CONCRETE PAVEMENT.

6. SAWCUT AND REMOVE BITUMINOUS CONCRETE PAVEMENT.

7. 12'8" X 20'0" DUMPSTER PAD AND CATCH BASIN TO REMAIN. REPAIR DAMAGED CONCRETE. AS PER CONCRETE REPAIR SPECIFICATION.

N

City of Lowell Public Schools

Watermark
175 Cabot Street • Lowell, MA 01854
Phone: 978.452.9696 • Fax: 978.453.9988

MARK	DESCRIPTION	DATE	APPR.
A	ADDENDUM 2	9/18/14	GPF
0	ISSUED FOR BID	9/3/14	GPF

CONCRETE SIDEWALK, CURB AND PAVEMENT REPAIRS MCAVINNUE ELEMENTARY SCHOOL LOWELL PUBLIC SCHOOLS CONSTRUCTION PLAN

C-101

SHEET 2 OF 5

Plot Date: 9/17/2014 2:58:42 PM File Path: J:\01 Projects\14XXX\14401-05 Lowell Public Schools Concrete Repairs\11.0 Working Files\11.1 Drawings\11.1.1 Sheet Files\MCAVINNUE\C-101 MCAVINNUE.dwg